


aluminum channel shaped box  
returns painted to match  
light brushed aluminum satin gloss  
c/w pan & embossed polycarbonate face  
1" wide PVC retainer painted to match  
light brushed aluminum satin gloss  
illuminated with:  
(2) F60 T12/HO fluorescent lamps  
(2) F72 T12/HO fluorescent lamps  
(1) F84 T12/HO fluorescent lamp  
(1) UNIESB848-46 120V ballast  
sign installed flush to wall


Area: 46.9 sq. ft.  
Weight: 150 lbs.

**SHOP DRAWING - APPROVED as noted**  
SUBMITTALS ARE REVIEWED FOR CONFORMANCE WITH DESIGN INTENT AND GENERAL COMPLIANCE WITH THE CONTRACT DOCUMENTS ONLY. NOTATIONS DO NOT AUTHORIZE CHANGES TO THE VALUE OF THE CONTRACT.  
**OPAL ENGINEERING INC.**  
BY: saw DATE: sept 21 2015

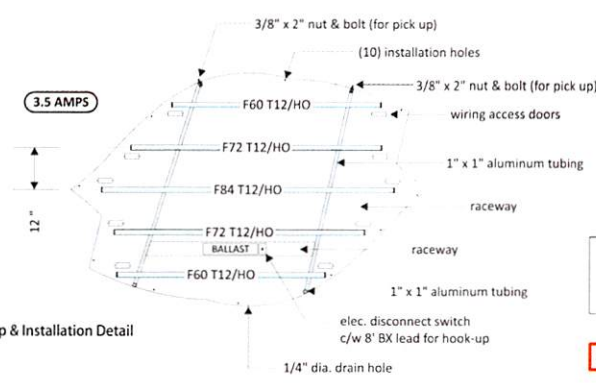

PMS 185C RED	PMS 1375C ORANGE	PMS 300C BLUE	WHITE

**NOTE: Interior of sign box painted white.**

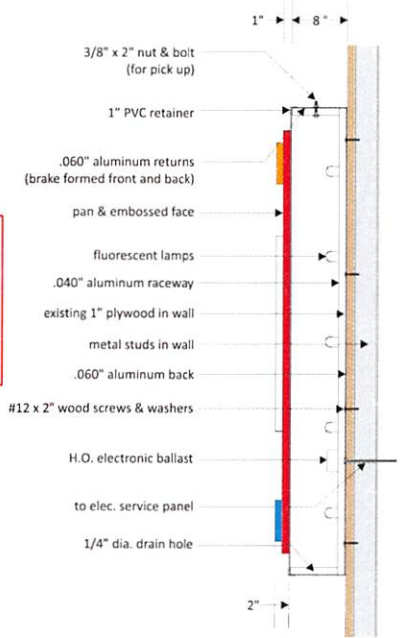

**Section View**  
Scale: 3/4"=1'

Scale: 3/8"=1'  
Qty. \_\_\_1\_\_\_

Drawing: Shop Drawing	Revisions: *
Drawn By: bl	
Date: 02/20/15	
Page: 1 of 9	File: DQ/Template/5 Door Cake & Treats, Blue

Approved By:

ph.905.639.1832 • fx.905.639.7132  
www.sunsetneon.com

Dairy Queen 27372  
5 Ft. Logo Fascia Sign Box  
10074 Highway 97  
Lake Country BC.V4V 1H1

